

STATE ENGINEER
Salem, Oregon

LANE
6070

Well Record


STATE WELL NO. 15/4W-17N(1)
COUNTY Lane
APPLICATION NO. GR-789

OWNER: Cyrel Schooling MAILING ADDRESS: 854 Lingo Lane

LOCATION OF WELL: Owner's No. #2 CITY AND STATE: Junction City, Oregon

SW 1/4 SW 1/4 Sec. 17 T. 15 S. R. 4 W., W.M.

Bearing and distance from section or subdivision corner 1033 ft. E. to a pt. 642 ft. N of SW corner of section 17.

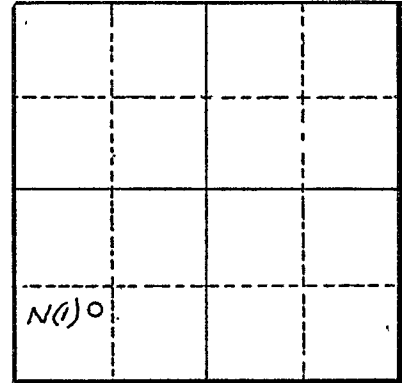

Section 17

Altitude at well -

TYPE OF WELL: Driven Date Constructed 1942

Depth drilled 30 ft. Depth cased

CASING RECORD:

4 in. pipe

FINISH:

AQUIFERS:

WATER LEVEL:

15 feet

PUMPING EQUIPMENT: Type F.M. elect. - Deming 2 1/2 in. H.P. 10
Capacity 250 G.P.M.

WELL TESTS:

Drawdown 4 ft. after hours 250 G.P.M.
Drawdown ft. after hours G.P.M.

USE OF WATER Irrigation Temp. °F. 19

SOURCE OF INFORMATION GR-789

DRILLER or DIGGER

ADDITIONAL DATA:

Log None Water Level Measurements Chemical Analysis Aquifer Test

REMARKS: