

STATE ENGINEER  
Salem, Oregon

LANE  
6071

# Well Record

STATE WELL NO. 15/4W-17N(2)  
COUNTY Lane  
APPLICATION NO. GR-608

OWNER: Cyrel Schooling


MAILING ADDRESS: 854 Lingo Lane

LOCATION OF WELL: Owner's No. #1

CITY AND STATE: Junction City, Oregon

SW 1/4 SW 1/4 Sec. 17 T. 15 N. S. R. 4 W., W.M.

Bearing and distance from section or subdivision corner

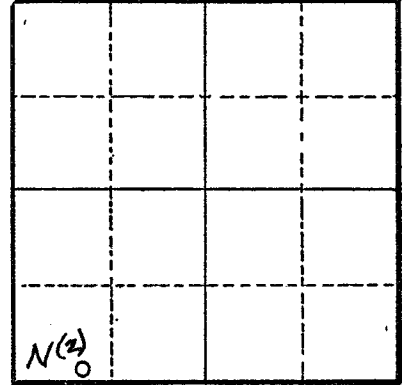

Section

Altitude at well 650 feet

TYPE OF WELL: Driven Date Constructed 1942

Depth drilled 30 ft. Depth cased

### CASING RECORD:

4 in. pipe

### FINISH:

### AQUIFERS:

### WATER LEVEL:

15 feet

PUMPING EQUIPMENT: Type F.M. elect.- Deming 2 1/2 in. H.P. 10  
Capacity 250 G.P.M.

### WELL TESTS:

Drawdown 4 ft. after hours 250 G.P.M.  
Drawdown ft. after hours G.P.M.

USE OF WATER Irrigation Temp. °F., 19

SOURCE OF INFORMATION GR- 608

DRILLER or DIGGER

### ADDITIONAL DATA:

Log None Water Level Measurements Chemical Analysis Aquifer Test

### REMARKS: