

STATE ENGINEER  
Salem, Oregon

LANE  
6072

# Well Record

STATE WELL NO. 15/4W-17P(1)  
COUNTY Lane  
APPLICATION NO. GR- 790

OWNER: Cyrel Schooling


MAILING ADDRESS: 854 Lingo Lane

LOCATION OF WELL: Owner's No. #3

CITY AND STATE: Junction, City, Oregon

SE 1/4 SW 1/4 Sec. 17 T. 15 S., R. 4 W., W.M.

Bearing and distance from section or subdivision corner

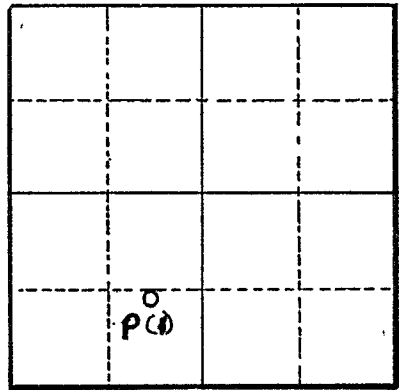

Section 17

Altitude at well 650 feet

TYPE OF WELL: Driven Date Constructed 1942

Depth drilled 30 ft. Depth cased

CASING RECORD:  
4 in. pipe

FINISH:

AQUIFERS:

WATER LEVEL:  
15 feet

PUMPING EQUIPMENT: Type Tractor - Gardner denver 2 1/2 in. H.P. 26  
Capacity 300 G.P.M.

WELL TESTS:  
Drawdown 4 ft. after hours 250 G.P.M.  
Drawdown ft. after hours G.P.M.

USE OF WATER Irrigation Temp. °F., 19

SOURCE OF INFORMATION GR- 790

DRILLER or DIGGER

ADDITIONAL DATA:  
Log None Water Level Measurements Chemical Analysis Aquifer Test

REMARKS: