

STATE ENGINEER
Salem, Oregon

LANE
6073

Well Record

GR- 1109

STATE WELL NO. 15/4W-17E(2)
COUNTY Lane
APPLICATION NO. GR- 841

OWNER: L. J. Bryson


MAILING ADDRESS: 102 Lingo Lane

LOCATION OF WELL: Owner's No. #2

CITY AND STATE: Junction City, Oregon

SE 1/4 SW 1/4 Sec. 17 T. 15 S., R. 4 W., W.M.

Bearing and distance from section or subdivision corner 2600' E. & 1200' N. from SW cor. Sec. 17

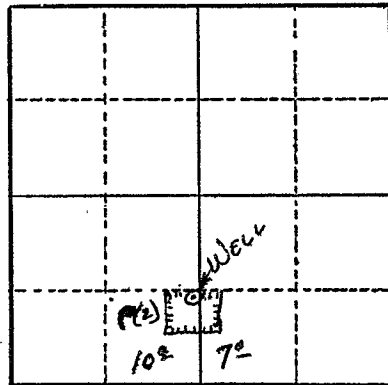

Section 17

Altitude at well 300 ft.

TYPE OF WELL: Driven Date Constructed 1948

Depth drilled 21 ft. Depth cased 21 ft.

CASING RECORD:

4 inch

FINISH:

AQUIFERS:

WATER LEVEL:

16 ft.

PUMPING EQUIPMENT: Type Rain-O-Flow 2 1/2 in. H.P. 15
Capacity G.P.M.

WELL TESTS:

Drawdown ft. after hours G.P.M.
Drawdown ft. after hours G.P.M.

USE OF WATER Irrigation Temp. °F. 19

SOURCE OF INFORMATION G. R. Record

DRILLER or DIGGER

ADDITIONAL DATA:

Log N.A. Water Level Measurements Chemical Analysis Aquifer Test

REMARKS:

Irrigation of 17 acres.