

STATE ENGINEER
Salem, Oregon

LANE
62074

Well Record

STATE WELL NO. 15/14W-17Q
COUNTY Lane
APPLICATION NO. GR-934

OWNER: Clarence Edmonds MAILING ADDRESS: Rt. 3

LOCATION OF WELL: Owner's No. _____ CITY AND STATE: Junction City

SW $\frac{1}{4}$ SE $\frac{1}{4}$ Sec. 17 T. 15 ^N S., R. 4 ^E W., W.M.


Bearing and distance from section or subdivision corner SE cor. Sec. 17 W. 2640' thence N. 330' to well

Altitude at well 307 ft.

TYPE OF WELL: drilled Date Constructed May 1945

Depth drilled 27 ft. Depth cased 27 ft.

CASING RECORD: 4 inch steel pipe 0 - 27 ft.

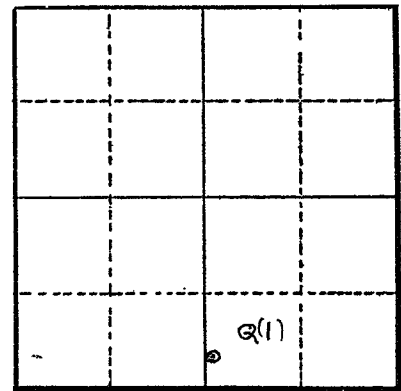

Section 17

FINISH:

AQUIFERS:

WATER LEVEL:

PUMPING EQUIPMENT: Type 2 1/2 in. A.C. centrifugal H.P. 15 elec. G.E.
Capacity 400 G.P.M.

WELL TESTS:
Drawdown 8 ft. after _____ hours 400 G.P.M.
Drawdown _____ ft. after _____ hours _____ G.P.M.

USE OF WATER Irrigation Temp. _____ °F., 19
SOURCE OF INFORMATION owner

DRILLER or DIGGER _____
ADDITIONAL DATA:
Log NA Water Level Measurements _____ Chemical Analysis _____ Aquifer Test _____

REMARKS: