

STATE ENGINEER
Salem, Oregon

LANE
6075

Well Record

STATE WELL NO. 15/4W-17Q
COUNTY Lane
APPLICATION NO.

OWNER: Raymond W. Smith


MAILING ADDRESS: Rt. 3

LOCATION OF WELL: Owner's No. 2

CITY AND STATE: Junction City, Oregon

SW 1/4 SE 1/4 Sec. 17 T. 15 N S, R. 4 W., W.M.

Bearing and distance from section or subdivision
corner 1170' E. & 720' N. of NE cor. of John D.
Hornbuckle DIC

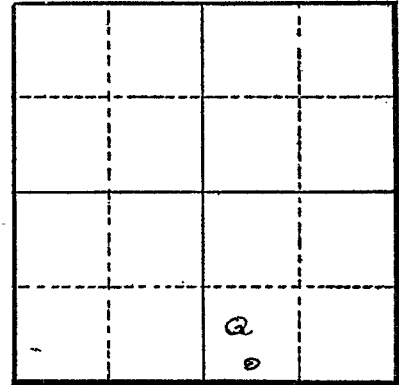

Section 17

Altitude at well 340 ft.

TYPE OF WELL: driven Date Constructed June, 1952

Depth drilled 20 ft. Depth cased 20 ft.

CASING RECORD: 4 inch 0 - 20 ft.

FINISH:

AQUIFERS:

WATER LEVEL: 12 ft.

PUMPING EQUIPMENT: Type F.M. & Co. 2 in. centrifugal H.P. 15 elec.
Capacity 250 G.P.M.

WELL TESTS:

Drawdown ft. after hours G.P.M.

Drawdown ft. after hours G.P.M.

USE OF WATER Temp. °F., 19

SOURCE OF INFORMATION owner

DRILLER or DIGGER

ADDITIONAL DATA:

Log NA Water Level Measurements Chemical Analysis Aquifer Test

REMARKS: