

STATE ENGINEER
Salem, Oregon

LANE
6076

Well Record

STATE WELL NO. 15/4W-17R
COUNTY Lane
APPLICATION NO. GR-4041

OWNER: Dale Burgess


MAILING ADDRESS: Route 1

LOCATION OF WELL: Owner's No.

CITY AND STATE: Harrisburg, Oregon

SE 1/4 SE 1/4 Sec. 17 T. 15 S., R. 4 W., W.M.

Bearing and distance from section or subdivision corner 697' N. & 495' W. of SE Cor. Sec. 17

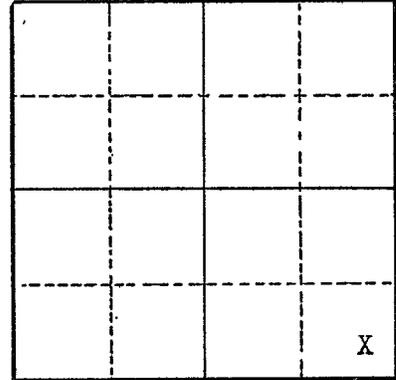

Section 17

Altitude at well

TYPE OF WELL: Driven Date Constructed 1942

Depth drilled 20 ft. Depth cased 20 ft.

CASING RECORD:

4 inch well casing set to 20 feet

FINISH:

Standard perforations from 17 to 20 feet

AQUIFERS:

WATER LEVEL:

12 feet below surface

PUMPING EQUIPMENT: Type Allis Chalmers centrifugal 2 1/2" H.P. 15
Capacity 180 G.P.M.

WELL TESTS:

Drawdown ft. after hours G.P.M.
Drawdown ft. after hours G.P.M.

USE OF WATER Irrigation Temp. °F., 19

SOURCE OF INFORMATION Well Registration Statement Cart. # GR-3642

DRILLER or DIGGER

ADDITIONAL DATA:

Log Water Level Measurements Chemical Analysis Aquifer Test

REMARKS:

Log:		Thickness	Depth to Bottom
Top soil (loam)		5	15
Sand & gravel		15	0