

STATE ENGINEER
Salem, Oregon

LANE
6104

Well Record

STATE WELL NO. 15/4W-18A(1)
COUNTY Lane
APPLICATION NO. GR. 1211

GR- 1171

OWNER: Henry L. & Grace E. Pace


MAILING ADDRESS: Rt. 3, Box 903

LOCATION OF WELL: Owner's No. #1

CITY AND STATE: Junction City, Oregon

NE 1/4 NE 1/4 Sec. 18 T. 15 N. S. R. 4 W., W.M.

Bearing and distance from section or subdivision corner 900' W. & 1150' S. from NE cor. Sec. 18.

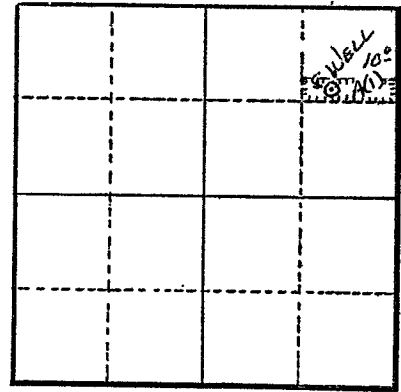

Section 18

Altitude at well 290 ft.

TYPE OF WELL: Driven Date Constructed 1950

Depth drilled 21 ft. Depth cased 21 ft.

CASING RECORD:

4 inch

FINISH:

AQUIFERS:

WATER LEVEL:

13 ft.

PUMPING EQUIPMENT: Type Myers 2 x 2 1/2 in. H.P. Tractor
Capacity 75 G.P.M.

WELL TESTS:

Drawdown 6 ft. after 7000 hours G.P.M. H.
Drawdown ft. after hours G.P.M.

USE OF WATER Irrigation Temp. °F. 19

SOURCE OF INFORMATION G. R. Record

DRILLER or DIGGER

ADDITIONAL DATA:

Log N.A. Water Level Measurements Chemical Analysis Aquifer Test

REMARKS:

Irrigation of 10 acres.