

LANE
6106


Well Record

OWNER: W. H. Lynch
MAILING ADDRESS: Route 3

LOCATION OF WELL: Owner's No. _____
CITY AND STATE: Junction City, Oregon

SE 1/4 NW 1/4 Sec. 18 T. 15 S., R. 4 W., W.M.

Bearing and distance from section or subdivision
corner 3330' W. & 1440' S. from NE Cor. Sec. 18

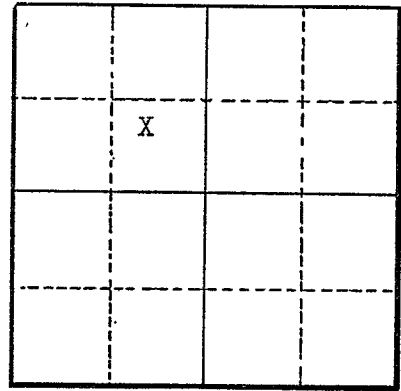

Section 18

Altitude at well _____

TYPE OF WELL: Driven Date Constructed 1941

Depth drilled 20 ft. Depth cased 20 ft.

CASING RECORD:

4 inch steel well casing set to 20 feet

FINISH:

1" x 4" 8/ft. from 16 to 20 feet

AQUIFERS:

WATER LEVEL:

8 feet below surface

PUMPING EQUIPMENT: Type Fairbanks Morse 2" centrifugal H.P. 10
Capacity 300 G.P.M.

WELL TESTS:

Drawdown _____ ft. after _____ hours _____ G.P.M.
Drawdown _____ ft. after _____ hours _____ G.P.M.

USE OF WATER Irrigation Temp. _____ °F. _____, 19

SOURCE OF INFORMATION Well Registration Statement Cert. # GR-3663

DRILLER or DIGGER _____

ADDITIONAL DATA:

Log Water Level Measurements _____ Chemical Analysis _____ Aquifer Test _____

REMARKS:

	Thickness	Depth to Bottom
Log		
Silt loam	4	4
Fine sand	4	8
Sand & gravel	12	20