

LANE
6107


Well Record

OWNER: A. D. Anderson
MAILING ADDRESS: R. R. # 3

LOCATION OF WELL: Owner's No. _____
CITY AND STATE: Junction City, Oregon

SE 1/4 NW 1/4 Sec. 18 T. 15 N. S. R. 4 W., W.M.

Bearing and distance from section or subdivision
corner 3380' N. & 1420' E. of SW cor. Sec. 18

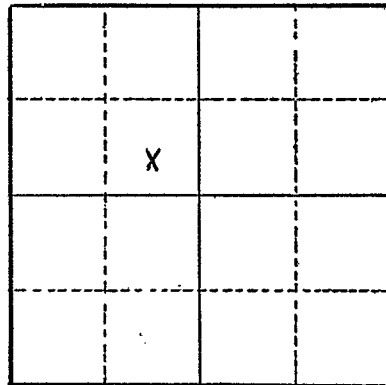

Section 18

Altitude at well _____

TYPE OF WELL: Driven Date Constructed 1953

Depth drilled 21 feet Depth cased 21 feet

CASING RECORD:

6 inch casing set to 21 feet

FINISH:

Standard perforations from 19 to 21 feet

AQUIFERS:

WATER LEVEL:

10 feet below surface

PUMPING EQUIPMENT: Type Cornell centrifugal H.P. 15
Capacity 250 G.P.M.

WELL TESTS:

Drawdown 2 ft. after 400 hours G.P.M.

Drawdown _____ ft. after _____ hours G.P.M.

USE OF WATER Irrigation Temp. °F. 19

SOURCE OF INFORMATION Wall Registration Statement

DRILLER or DIGGER _____

ADDITIONAL DATA:

Log Water Level Measurements _____ Chemical Analysis _____ Aquifer Test _____

REMARKS:

Log:	Thickness	Depth to Bottom
Loam	4	17
Coarse sand	4	13
Coarse gravel	13	0

5362