

STATE ENGINEER  
Salem, Oregon

LANE  
6108

# Well Record


STATE WELL NO. 15/4W-18G  
COUNTY Lane  
APPLICATION NO. GR-4065

OWNER: W. H. Lynch  
MAILING ADDRESS: Route 3

LOCATION OF WELL: Owner's No. STATE: Junction City, Oregon

SW 1/4 NE 1/4 Sec. 18 T. 15 S., R. 4 W., W.M.

Bearing and distance from section or subdivision  
corner 1430' S. & 1490' W. from NE Cor. Sec. 18

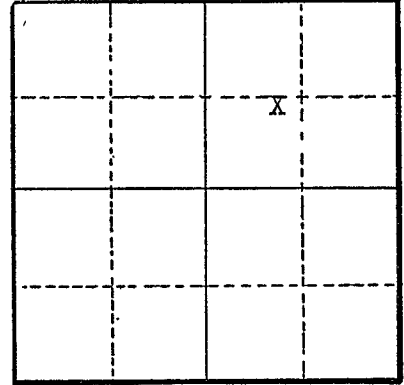

Section 18

Altitude at well

TYPE OF WELL: Driven Date Constructed 1943

Depth drilled 22 ft. Depth cased 22 ft.

### CASING RECORD:

4 inch steel well casing set to 22 feet

### FINISH:

Slotted perforations 3" x 3" from 19 to 22 feet

### AQUIFERS:

### WATER LEVEL:

8 feet below surface

PUMPING EQUIPMENT: Type Demming centrifugal H.P. 15  
Capacity 300 G.P.M.

### WELL TESTS:

Drawdown ft. after hours G.P.M.  
Drawdown ft. after hours G.P.M.

USE OF WATER Irrigation Temp. °F., 19

SOURCE OF INFORMATION Well Registration Statement Cert. # GR-3661

DRILLER or DIGGER

### ADDITIONAL DATA:

Log  Water Level Measurements Chemical Analysis Aquifer Test

### REMARKS:

Log	Thickness	Depth to Bottom
Silt loam	4	4
Find sand	4	8
Sand & gravel	14	22