

LANE 6111

STATE ENGINEER
Salem, Oregon

LANE
Well

Well Record

GR- 1489


STATE WELL NO. 15/4W-18H
COUNTY Lane
APPLICATION NO. GR- 1546

OWNER: John Dudley Nelson
MAILING ADDRESS: Rt. 3

LOCATION OF WELL: Owner's No. _____
CITY AND STATE: Junction City, Oregon

SE 1/4 NE 1/4 Sec. 18 T. 15 S., R. 4 W., W.M.

Bearing and distance from section or subdivision
corner 2970' N. & 50' W. from SE cor. Sec. 18

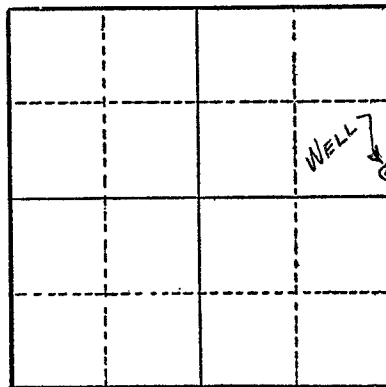

Section 18

Altitude at well 200'

TYPE OF WELL: Driven Date Constructed 1948

Depth drilled 21' Depth cased 21'

CASING RECORD:
4"

FINISH:

Perforated with 4" cuts from 17' to 20'

AQUIFERS:

WATER LEVEL:
9'

PUMPING EQUIPMENT: Type Pacific H.P. 3
Capacity 40 G.P.M.

WELL TESTS:
Drawdown 0 ft. after _____ hours 500 G.P.M.
Drawdown _____ ft. after _____ hours _____ G.P.M.

USE OF WATER Irrigation Temp. _____ °F. _____, 19

SOURCE OF INFORMATION GR Record

DRILLER or DIGGER _____

ADDITIONAL DATA:
Log _____ Water Level Measurements _____ Chemical Analysis _____ Aquifer Test _____

REMARKS:

Log: Sandy loam 0 to 2 ft.
Clay loam 2 to 6 ft.
Sand & gravel 6 to 21 ft.

Irrigation of 5 acres.



Oregon Water Resources Department
 725 Summer Street NE, Suite A
 Salem Oregon 97301
 (503) 986-0900
 www.wrd.state.or.us

Application for Well ID Number

RECEIVED

AUG 04 2016

WATER RESOURCES DEPT
 SALEM, OREGON

Do not complete if the well already has a Well Identification Number.

I. OWNER INFORMATION

Current Owner Name (please print): Pamela A. McIntire (Trustee The Nelson Trust)
 Mailing Address: 790 Oak St
 City, State, Zip: Junction City OR 97448
 Mail Well ID Tag to: SAME AS ABOVE In Care Of (C/O)
 Name & Address: _____
 City, State, Zip: _____

II. WELL LOCATION INFORMATION (Please fill out as completely as possible)

Township: 15 (North / South) Range: 04 (East / West) Section: 18 SE 1/4 of the NE 1/4
 Tax Lot (usually last 3-5 numbers of Tax Map #): 300 County Lane
 GPS Coordinates: _____
 Street Address of Well, City: 95894 Howard Ln Junction City OR 97448
 If the property had a different street address in the past: 601 Howard Ln Junction City OR 97448

III. GENERAL WELL INFORMATION (Please fill out as completely as possible, AND attach copy of Well Log, if available)

Use of Well (domestic, irrigation, commercial, industrial, monitoring): Irrigation
 Date Well Constructed (or property built): 1948 Total Well Depth: 21' Casing Diameter: 4"
 Owner at time the well was constructed (if known): John Dudley Nelson Well Log # (if known): LANE 6111
 Other Information: _____

SUBMITTED BY (please print): Paul E. McIntire
 PHONE: 541 998-4663 EMAIL &/or FAX: pempam73@hotmail.com

Send application to: Oregon Water Resources Department 725 Summer St NE, Suite A, Salem, Oregon 97301; or fax to (503) 986-0902. Applications are processed in the order they are received, and Well ID Numbers are mailed within 4-5 business days.

For Official Use Only by the Oregon Water Resources Department:

Received Date:

8-4-16

Well Log Number:

LANE 6111

Well Identification #:

L-123489