

STATE ENGINEER  
Salem, Oregon

*LANE  
6112*

# Well Record


STATE WELL NO. 15/4W-18H(1) *ad1*  
COUNTY Lane  
APPLICATION NO. GR-698

OWNER: D. LeRoy Adams MAILING ADDRESS: Rt. 3

LOCATION OF WELL: Owner's No. 1 CITY AND STATE: Junction City, Oregon

SE 1/4 NE 1/4 Sec. 18 T. 15 S., R. 4 W., W.M.

Bearing and distance from section or subdivision  
corner 2000' S. & 132' W. from NE cor. Sec. 18

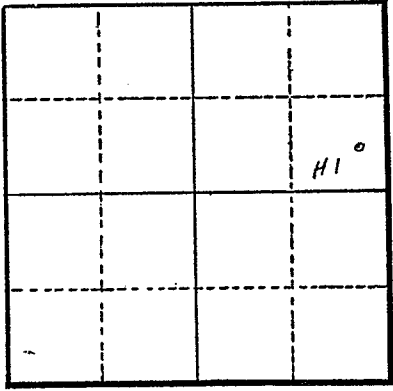

Section 18

Altitude at well 300 ft. Interpolated

TYPE OF WELL: drilled Date Constructed June, 1952

Depth drilled 29 ft. Depth cased 29 ft.

CASING RECORD: 4 inch

FINISH:

AQUIFERS:

WATER LEVEL: 12 ft.

PUMPING EQUIPMENT: Type Pacific H.P. 15  
Capacity 300 G.P.M.

WELL TESTS:  
Drawdown 2 ft. after 450 hours G.P.M.  
Drawdown          ft. after          hours G.P.M.

USE OF WATER irrigation 12 acres Temp.          °F.         , 19        

SOURCE OF INFORMATION GR-698

DRILLER or DIGGER Everitt Scott; Harrisburg, Oregon

ADDITIONAL DATA:  
Log          Water Level Measurements          Chemical Analysis          Aquifer Test         

REMARKS:  
*See log of new well drilled for replacement of this well. New well 15/4W-18 ad 2  
7/5/68 by O.B. Nye  
Earl & Crine Adams.*