

STATE ENGINEER  
Salem, Oregon

LANE  
6114

# Well Record


STATE WELL NO. 15/4W-18J  
COUNTY Lane  
APPLICATION NO. GR-3653

OWNER: William F. McEldowney  
MAILING ADDRESS: 385 Howard Lane

CITY AND STATE: Junction City, Oregon

LOCATION OF WELL: Owner's No. N. E.  
NE 1/4 SE 1/4 Sec. 18. T. 15 S., R. 4 W., W.M.

Bearing and distance from section or subdivision  
corner 1710' N. & 160' W. of SE Cor. Sec. 18

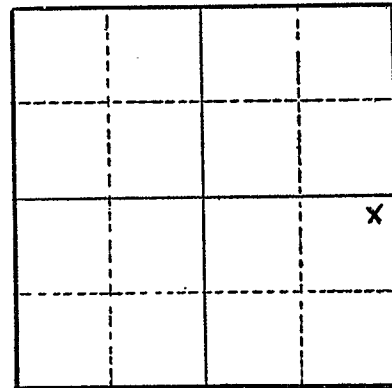

Section 18

Altitude at well

TYPE OF WELL: Driven Date Constructed 1952

Depth drilled 27 feet Depth cased 27 feet

### CASING RECORD:

3 inch casing set to 27 feet

### FINISH:

Standard perforations from 24 to 27 feet

### AQUIFERS:

### WATER LEVEL:

12 feet below surface

PUMPING EQUIPMENT: Type Barnes centrifugal H.P. 1  
Capacity 120 G.P.M.

### WELL TESTS:

Drawdown 3 ft. after 300 hours G.P.M.  
Drawdown ft. after hours G.P.M.

USE OF WATER Irrigation Temp. °F., 19  
SOURCE OF INFORMATION Well Registration Statement

DRILLER or DIGGER

### ADDITIONAL DATA:

Log X Water Level Measurements Chemical Analysis Aquifer Test

### REMARKS:

Log:

Loam top soil  
Sand & gravel

Thickness	Depth to Bottom
4	23
23	0