

STATE ENGINEER
Salem, Oregon

LANE
6115

Well Record

STATE WELL NO. 15/4W - 18J
COUNTY LANE
APPLICATION NO. GR-2274

OWNER: D. L. Nickerson


MAILING ADDRESS: Rt. 3, Box 877

LOCATION OF WELL: Owner's No. #1

CITY AND STATE: Junction City, Oregon

NE $\frac{1}{4}$ SE $\frac{1}{4}$ Sec. 18 T. 15 ^{N.} S., R. 4 ^{E.} W., W.M.

Bearing and distance from section or subdivision corner 361.8' W.

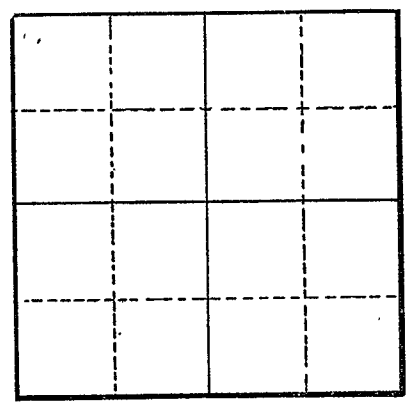

Section

Altitude at well

TYPE OF WELL: Drilled Date Constructed 1952

Depth drilled 25 Depth cased 7 $\frac{1}{2}$

CASING RECORD:

4-Inch

FINISH:

AQUIFERS:

Gravel

WATER LEVEL:

7-Feet

PUMPING EQUIPMENT: Type Berkeley H.P. 5
Capacity 125 G.P.M.

WELL TESTS:
Drawdown 1 $\frac{1}{2}$ ft. after hours Pumping 125 G.P.M.
Drawdown 1 $\frac{1}{2}$ ft. after hours Pumping 125 G.P.M.

USE OF WATER Irrigation Temp. °F., 19....

SOURCE OF INFORMATION GR-2167
DRILLER or DIGGER

ADDITIONAL DATA:
Log X Water Level Measurements Chemical Analysis Aquifer Test

REMARKS:

Gravel 25