

STATE ENGINEER
Salem, Oregon


LANE
6116

Well Record

STATE WELL NO. 15/4W-18M
COUNTY Lane
APPLICATION NO. GR-3667

OWNER: S. D. Anderson
MAILING ADDRESS: R. R. # 3
CITY AND STATE: Junction City, Oregon

LOCATION OF WELL: Owner's No. _____
NW 1/4 SW 1/4 Sec. 18 T. 15 S. R. 4 W., W.M.
Bearing and distance from section or subdivision
corner 1530' N. & 1140' E. of SW cor. Sec. 18

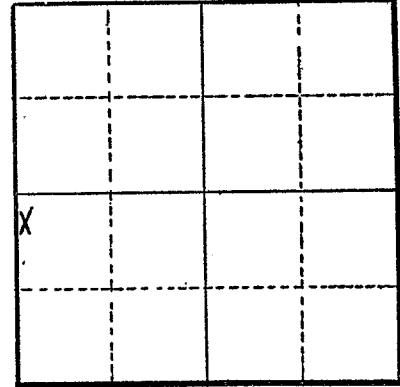

Section 18

Altitude at well _____

TYPE OF WELL: Driven Date Constructed 1948
Depth drilled 21 feet Depth cased 21 feet

CASING RECORD:

6 inch casing set to 21 feet

FINISH:

Standard perforations from 18 to 21 feet

AQUIFERS:

WATER LEVEL:

12 feet below surface

PUMPING EQUIPMENT: Type Bingham centrifugal H.P. 40
Capacity 300 G.P.M.

WELL TESTS:

Drawdown 2 ft. after 400 hours G.P.M.
Drawdown _____ ft. after _____ hours G.P.M.

USE OF WATER Irrigation Temp. °F. 19

SOURCE OF INFORMATION Well Registration Statement

DRILLER or DIGGER _____

ADDITIONAL DATA:

Log Water Level Measurements _____ Chemical Analysis _____ Aquifer Test _____

REMARKS:

Log:	Thickness	Depth to Bottom
Top soil (loam)	6	15
Sand	4	11
Coarse gravel	11	0

3363