

STATE ENGINEER
Salem, Oregon

LANE
6117

Well Record

STATE WELL NO. 15/4W-180
COUNTY Lane
APPLICATION NO. GR-1281

GR-1238

OWNER: Ezra and/or Ida Kropf


MAILING ADDRESS: 1400 Lingo Lane

LOCATION OF WELL: Owner's No.

CITY AND STATE: Junction City, Oregon

SW 1/4 SE 1/4 Sec. 18 T. 15 S. R. 4 W., W.M.

Bearing and distance from section or subdivision corner 1970' N82°W. from SE cor. Sec. 18.

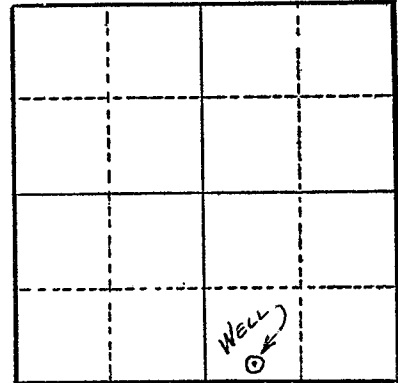

Section 18

Altitude at well 308 ft.

TYPE OF WELL: Driven Date Constructed 1949

Depth drilled 20 ft. Depth cased 20 ft.

CASING RECORD:

4 inch

FINISH:

Standard perforations from 17 to 20 ft.

AQUIFERS:

WATER LEVEL:

9 ft.

PUMPING EQUIPMENT: Type Berkeley 2 in. Cent. H.P. 5
Capacity 120 G.P.M.

WELL TESTS:

Drawdown 1 ft. after 300 hours G.P.M.
Drawdown ft. after hours G.P.M.

USE OF WATER Irrigation Temp. °F., 19

SOURCE OF INFORMATION G. R. Record

DRILLER or DIGGER

ADDITIONAL DATA:
Log Water Level Measurements Chemical Analysis Aquifer Test

REMARKS:

Log: Loam 0 to 6 ft.
Sandy gravel 6 to 20 ft.

Irrigation of 10 acres.