

STATE ENGINEER
Salem, Oregon

LANE
6118

Well Record

STATE WELL NO. 15/4W-18R
COUNTY Lane
APPLICATION NO. GR-813

OWNER: Kyle N. Howard


MAILING ADDRESS: Rt. 3

LOCATION OF WELL: Owner's No.

CITY AND STATE: Junction City, Oregon

SE 1/4 SE 1/4 Sec. 18 T. 15 S, R. 4 W., W.M.

Bearing and distance from section or subdivision
corner 62' to a pt. N. & 242' W. of SE cor. Sec. 18

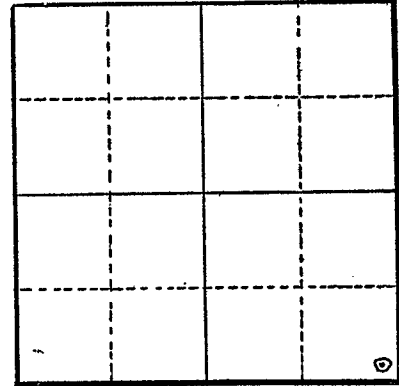

Section 18

Altitude at well 315 ft.

TYPE OF WELL: driven Date Constructed 1939

Depth drilled 26 ft. Depth cased

CASING RECORD:

FINISH:

AQUIFERS:

WATER LEVEL: 15 ft.

PUMPING EQUIPMENT: Type Fairbanks Morse 2 1/2 in. H.P. 10 elec.
Capacity 250 G.P.M.

WELL TESTS: not tested
Drawdown ft. after hours G.P.M.
Drawdown ft. after hours G.P.M.

USE OF WATER irrigation Temp. °F., 19

SOURCE OF INFORMATION owner

DRILLER or DIGGER

ADDITIONAL DATA:

Log X Water Level Measurements Chemical Analysis Aquifer Test

REMARKS:

Log: 6 ft. Willamette soil
The rest, sand & gravel, depth unknown