

STATE ENGINEER
Salem, Oregon

LANE
6119

Well Record

STATE WELL NO. 15/4W - 18R
COUNTY LANE
APPLICATION NO. GR-2275

OWNER: D. L. Nickerson


MAILING ADDRESS: Rt. 3, Box 877

LOCATION OF WELL: Owner's No. #2

CITY AND STATE: Junction City, Oregon

SE 1/4 SE 1/4 Sec. 18 T. 15 N. 4 E. W., W.M.

Bearing and distance from section or subdivision corner 127.33' W. and 999.22' S.

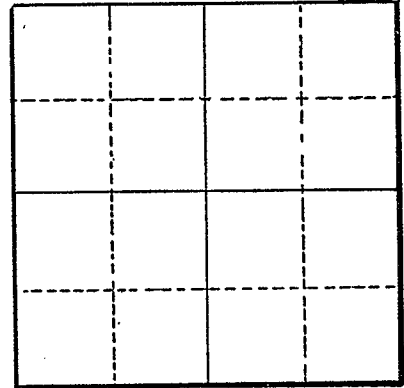

Section

Altitude at well

TYPE OF WELL: Drilled Date Constructed 1953

Depth drilled 21 Depth cased

CASING RECORD:

1 1/4-Inch

FINISH:

AQUIFERS:

Loam and gravel

WATER LEVEL:

6-Feet

PUMPING EQUIPMENT: Type General Electric H.P. 2 1/2
Capacity 75 G.P.M.

WELL TESTS:

Drawdown 7 1/2 ft. after hours Pumping 75 G.P.M.
Drawdown 75 ft. after hours Pumping 75 G.P.M.

USE OF WATER Irrigation & Domestic Temp. °F., 19

SOURCE OF INFORMATION GR-2168

DRILLER or DIGGER Walter Nelson

ADDITIONAL DATA:

Log X Water Level Measurements Chemical Analysis Aquifer Test

REMARKS:

Loam 6 21
Gravel 15 21