

STATE ENGINEER
Salem, Oregon

LANE
6139

Well Record


STATE WELL NO. 15/4W-19B
COUNTY Lane
APPLICATION NO. GR-2269
Cert. GR-2163

OWNER: C. C. Glenn & M. B. Glenn
MAILING ADDRESS: Rt. 3

LOCATION OF WELL: Owner's No. _____
CITY AND STATE: Junction City, Oregon

NW 1/4 NE 1/4 Sec. 19 T. 15 S., R. 4 W., W.M.

Bearing and distance from section or subdivision
corner 550' S. & 2965' E. from NW cor. Sec. 19

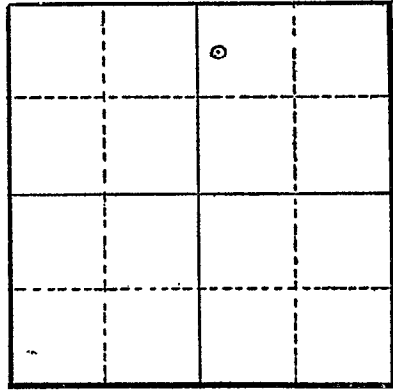

Section 19

Altitude at well _____

TYPE OF WELL: driven Date Constructed 1953

Depth drilled 27 ft. Depth cased 27 ft.

CASING RECORD: 4 inch

FINISH: Casing perforated from 23 to 27 feet

AQUIFERS: Sand and coarse gravel

WATER LEVEL: 12 ft. below land surface

PUMPING EQUIPMENT: Type cent. H.P. 5
Capacity 160 G.P.M.

WELL TESTS:
Drawdown 2 ft. after _____ hours pumping 300 G.P.M.
Drawdown _____ ft. after _____ hours _____ G.P.M.

USE OF WATER irrigation 10 acres Temp. °F. _____, 19
SOURCE OF INFORMATION GR-2269

DRILLER or DIGGER _____

ADDITIONAL DATA:
Log Water Level Measurements _____ Chemical Analysis _____ Aquifer Test _____

REMARKS: