

STATE ENGINEER
Salem, Oregon

LANE
6140


Well Record

STATE WELL NO. 15/4W - 19B
COUNTY LANE
APPLICATION NO. GR-2269

OWNER: C. C. Glenn & Milo Bernard Glenn
MAILING ADDRESS: Route 3, Junction City, Oregon
CITY AND STATE:

LOCATION OF WELL: Owner's No.
NW 1/4 NE 1/4 Sec. 19 T. 15 N. S., R. 4 E. W., W.M.

Bearing and distance from section or subdivision corner 550' S. and 2965' E.

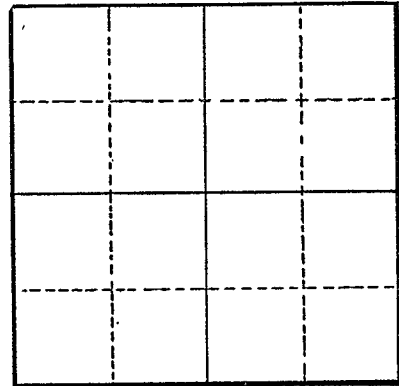

Section

Altitude at well

TYPE OF WELL: Driven Date Constructed 1953

Depth drilled 27 Depth cased 27

CASING RECORD:

4-Inch

FINISH:

Perforations from 23 to 27

AQUIFERS:

Top soil, sand and gravel

WATER LEVEL:

12-Feet

PUMPING EQUIPMENT: Type Cornell Centrifugal H.P. 5
Capacity 160 G.P.M.

WELL TESTS:
Drawdown 2 ft. after Pumping 300 G.P.M.
Drawdown ft. after hours G.P.M.

USE OF WATER Irrigation Temp. °F., 19

SOURCE OF INFORMATION GR-2163

DRILLER or DIGGER

ADDITIONAL DATA:
Log X Water Level Measurements Chemical Analysis Aquifer Test

REMARKS:

Loam top soil 4 23
Sand 4 15
Sand & coarse gravel 15 0

