

STATE ENGINEER
Salem, Oregon

LANE
6141


Well Record

GR- 1714

STATE WELL NO. 15/4W-19C
COUNTY Lane
APPLICATION NO. GR-1767

OWNER: Virgil B. Kenyon
MAILING ADDRESS: 1701 Lingo Lane
CITY AND STATE: Junction City, Oregon

LOCATION OF WELL: Owner's No.
NE 1/4 NW 1/4 Sec. 19 T. 15 S. R. 4 W., W.M.
Bearing and distance from section or subdivision
corner 1840' E. & 510' S. from NW cor. Sec. 19

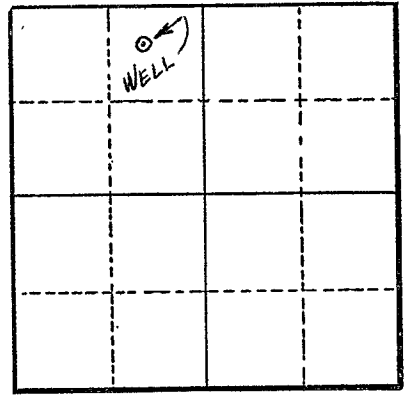

Section 19

Altitude at well
TYPE OF WELL: Driven Date Constructed 1946
Depth drilled 20 Depth cased 20'

CASING RECORD:
5"

FINISH:

AQUIFERS:

WATER LEVEL:
5'

PUMPING EQUIPMENT: Type Pacific 1 1/2" x 2" Cent. H.P. 5
Capacity 120 G.P.M.

WELL TESTS:
Drawdown ft. after hours G.P.M.
Drawdown ft. after hours G.P.M.

USE OF WATER Irrigation Temp. °F., 19

SOURCE OF INFORMATION GR Record

DRILLER or DIGGER Walt Nelson

ADDITIONAL DATA:
Log N.A. Water Level Measurements Chemical Analysis Aquifer Test

REMARKS:
Irrigation of 10 acres.