

STATE ENGINEER
Salem, Oregon

LANE
Cel 43

Well Record

STATE WELL NO. 15/4W-19N(1)
COUNTY Lane
APPLICATION NO. GR-1191


GR- 1152

OWNER: Ross A. Wagner
MAILING ADDRESS: Rt. 3

LOCATION OF WELL: Owner's No. #2
CITY AND STATE: Junction City, Oregon

SW 1/4 SW 1/4 Sec. 19 T. 15 S. R. 4 W., W.M.

Bearing and distance from section or subdivision corner 1056' N. & 270' E. from SW cor. Sec. 19.

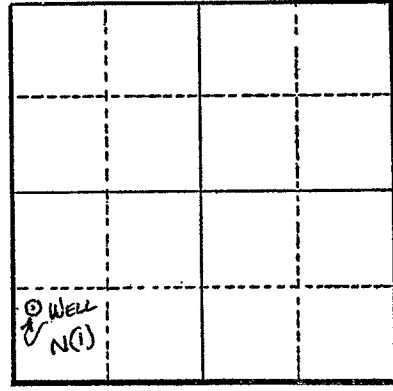

Section 19

Altitude at well 300 ft.

TYPE OF WELL: Driven Date Constructed 1949

Depth drilled 25 ft. Depth cased 25 ft.

CASING RECORD:
3 inch

FINISH:
Slotted perforations (3 x 3 in.) from 22 to 25 ft.

AQUIFERS:

WATER LEVEL:
10 ft.

PUMPING EQUIPMENT: Type Pacific 2 x 3 in. H.P. 5
Capacity 150 G.P.M.

WELL TESTS:
Drawdown 6 ft. after hours 200 G.P.M.
Drawdown ft. after hours G.P.M.

USE OF WATER Irrigation Temp. °F. 19

SOURCE OF INFORMATION G. R. Record

DRILLER or DIGGER Self

ADDITIONAL DATA:
Log Water Level Measurements Chemical Analysis Aquifer Test

REMARKS:

Log: Gravel from surface to bottom.

Irrigation of 41 acres.