

STATE ENGINEER  
Salem, Oregon

LANE  
6668

# Well Record

STATE WELL NO. 15/4W-20A  
COUNTY LANE  
APPLICATION NO. GR-2927

OWNER: Raymond G. Kolb

MAILING ADDRESS:

2150 Hwy 99E.


LOCATION OF WELL: Owner's No.

CITY AND STATE:

Junction City, Oregon

NE 1/4 NE 1/4 Sec. 20 T. 15 N. 4 E. S. R. W., W.M.

Bearing and distance from section or subdivision corner 800' W. and 270' S.

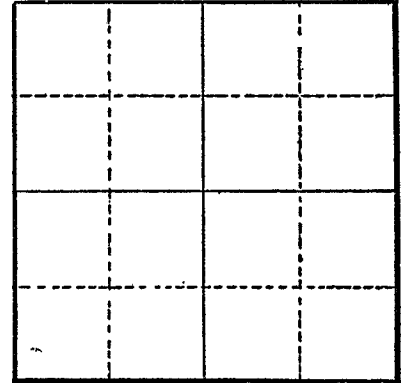

Section

Altitude at well

TYPE OF WELL: Driven Date Constructed 1950

Depth drilled 22 Depth cased 22

### CASING RECORD:

4-inch  
4-inch

### FINISH:

3' of perforated pipe from 19' to 22'  
regular pipe from 0 to 19'

### AQUIFERS:

Loam, sand, gravel and hardpan

### WATER LEVEL:

15-feet

PUMPING EQUIPMENT: Type Fairbanks Morse H.P. 10  
Capacity 200 G.P.M.

WELL TESTS: Drawdown 0? ft. after hours Pumping 200 G.P.M.  
Drawdown ft. after hours G.P.M.

USE OF WATER Irrigation Temp. °F., 19

SOURCE OF INFORMATION GR-2754

DRILLER or DIGGER

### ADDITIONAL DATA:

Log <sup>x</sup> Water Level Measurements Chemical Analysis Aquifer Test

### REMARKS:

Sand loam	7	7
Sand & gravel	10	17
Cemented hardpan	2	19
Water sand & gravel	3	22