

STATE ENGINEER  
Salem, Oregon

LANE  
Cel 71

Well Record

GR- 974

STATE WELL NO. 15/4W-20B(2)  
COUNTY Lane  
APPLICATION NO. GR-1008

OWNER: Walter & Andrea Nielsen

MAILING ADDRESS: Rt. 3


LOCATION OF WELL: Owner's No. #2

CITY AND STATE: Junction City, Oregon

NW 1/4 NE 1/4 Sec. 20 T. 15 S., R. 4 W., W.M.

Bearing and distance from section or subdivision

corner 605' S. & 530' W. from NE 1/16 cor. Sec. 20.

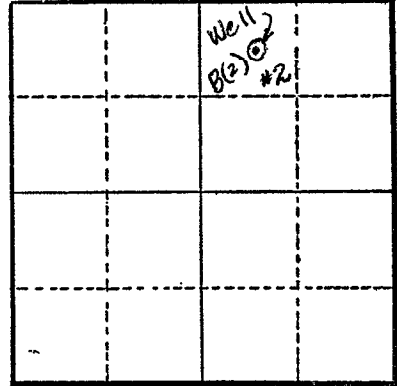

Section 20

Altitude at well 335 ft.

TYPE OF WELL: Driven Date Constructed 1953

Depth drilled 20 ft. Depth cased 20 ft.

CASING RECORD:

4 inch

FINISH:

AQUIFERS:

WATER LEVEL:

7 ft.

PUMPING EQUIPMENT: Type Cornell 2 1/2" H.P. 10  
Capacity 300 G.P.M.

WELL TESTS:

Drawdown ft. after hours G.P.M.  
Drawdown ft. after hours G.P.M.

USE OF WATER Irrigation Temp. °F. 19

SOURCE OF INFORMATION G.R. Record

DRILLER or DIGGER

ADDITIONAL DATA:

Log N.A. Water Level Measurements Chemical Analysis Aquifer Test

REMARKS:

Irrigation of 15 acres.