

STATE ENGINEER
Salem, Oregon

LANE
Well 72

Well Record


STATE WELL NO. 15/4W-20C(1)
COUNTY Lane
APPLICATION NO. GR-1009

GR- 975

OWNER: Walter & Andrea Nielsen
MAILING ADDRESS: Rt. 3

LOCATION OF WELL: Owner's No. #3
CITY AND STATE: Junction City, Oregon

NE 1/4 NW 1/4 Sec. 20 T. 15 S., R. 4 W., W.M.
Bearing and distance from section or subdivision
corner 28.53 ch. W. & 5.31 ch. S. from NE 1/16
cor. Sec. 20.

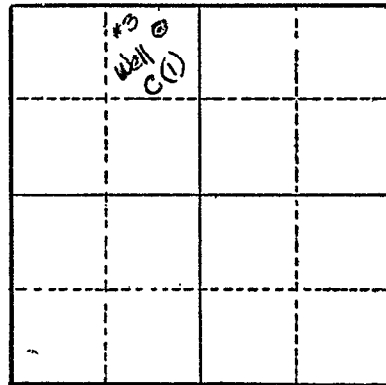

Section 20

Altitude at well 300 ft.

TYPE OF WELL: Driven Date Constructed 1953

Depth drilled 22 ft. Depth cased 20 ft.

CASING RECORD:

4 inch

FINISH:

AQUIFERS:

WATER LEVEL:

15 ft.

PUMPING EQUIPMENT: Type Gardner-Denver 3" Cent. H.P. Tractor
Capacity 400 G.P.M.

WELL TESTS:

Drawdown ft. after hours G.P.M.
Drawdown ft. after hours G.P.M.

USE OF WATER Irrigation Temp. °F., 19

SOURCE OF INFORMATION G.R. Record

DRILLER or DIGGER

ADDITIONAL DATA:

Log N.A. Water Level Measurements Chemical Analysis Aquifer Test

REMARKS:

Irrigation of 10 acres,