


LANE
6673

Well Record

OWNER: Martin G. Strome
MAILING ADDRESS: 1425 Hwy. 99E
CITY AND STATE: Junction City, Oregon

LOCATION OF WELL: Owner's No. _____
SE 1/4 NW 1/4 Sec. 20 T. 15 S., R. 4 W., W.M.
Bearing and distance from section or subdivision
corner 4160' S. 70° W. from NE cor. Sec. 20

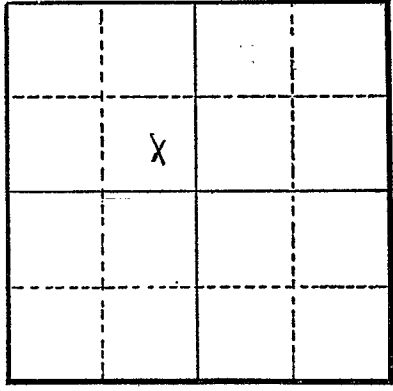

Section 20

Altitude at well _____
TYPE OF WELL: Driven Date Constructed 1938
Depth drilled 21 feet Depth cased 21 feet

CASING RECORD:

4 inch commercial well pipe set to 21 feet

FINISH:

4" of 4" perforated regular pipe from 17 to 21 feet

AQUIFERS:

WATER LEVEL:

10 feet below surface

PUMPING EQUIPMENT: Type Rain-Flow H.P. 20
Capacity 650 G.P.M.

WELL TESTS:

Drawdown 4 ft. after _____ hours 650 G.P.M.
Drawdown _____ ft. after _____ hours _____ G.P.M.

USE OF WATER Irrigation Temp. _____ °F., 19

SOURCE OF INFORMATION Well Registration Statement

DRILLER or DIGGER Everett Scott

ADDITIONAL DATA:

Log Water Level Measurements _____ Chemical Analysis _____ Aquifer Test _____

REMARKS:

Log:	Thickness	Depth to Bottom
Silt loam	2	2
Silty clay loam	2	4
Sand	4	8
Sand & gravel	13	21