

STATE ENGINEER  
Salem, Oregon

**LANE**  
6175

# Well Record


STATE WELL NO. 15/LW-20G  
COUNTY Lane  
APPLICATION NO. GR-3149

OWNER: Earl Adams  
MAILING ADDRESS: 1801 99E

LOCATION OF WELL: Owner's No. \_\_\_\_\_  
CITY AND STATE: Junction City, Oregon

SW 1/4 NE 1/4 Sec. 20 T. 15 S., R. 4 W., W.M.

Bearing and distance from section or subdivision  
corner 2230' S. and 1700' W.

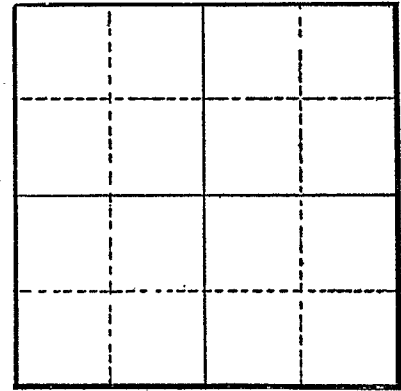

Section \_\_\_\_\_

Altitude at well \_\_\_\_\_

TYPE OF WELL: Driven Date Constructed 1949

Depth drilled 21' Depth cased 21'

CASING RECORD:  
3"

FINISH:  
standard perforations from 18 to 21

AQUIFERS:  
soil (loam)  
sand, gravel

WATER LEVEL:  
12'

PUMPING EQUIPMENT: Type Pacific Centrifugal H.P. 3  
Capacity 180 G.P.M.

WELL TESTS:  
Drawdown 3 ft. after \_\_\_\_\_ hours pumping 200 G.P.M.  
Drawdown \_\_\_\_\_ ft. after \_\_\_\_\_ hours \_\_\_\_\_ G.P.M.

USE OF WATER Irrigation Temp. °F. \_\_\_\_\_, 19

SOURCE OF INFORMATION GR-2950

DRILLER or DIGGER \_\_\_\_\_

ADDITIONAL DATA:  
Log  Water Level Measurements \_\_\_\_\_ Chemical Analysis \_\_\_\_\_ Aquifer Test \_\_\_\_\_

REMARKS:  
top soil (loam) 6 15  
sand & gravel 15 0