

STATE ENGINEER  
Salem, Oregon


LANE  
6176

# Well Record

STATE WELL NO. 15/~~AW~~-20L  
COUNTY Lane  
APPLICATION NO. GR-3673

OWNER: Martin G. Strome  
MAILING ADDRESS: 1425 Hiway 99E  
CITY AND STATE: Junction City, Oregon

LOCATION OF WELL: Owner's No. \_\_\_\_\_  
NE 1/4 SW 1/4 Sec. 20 T. 15 S., R. 4 W., W.M.  
Bearing and distance from section or subdivision  
corner 5050' S. 42° 30' W. from NE cor. Sec. 20

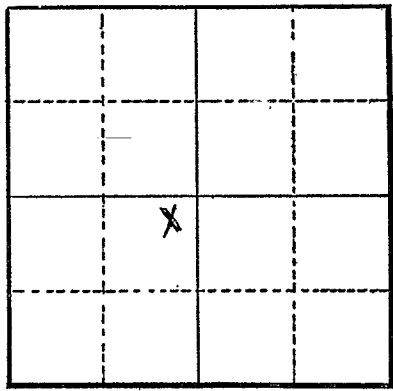

Section 20

Altitude at well \_\_\_\_\_

TYPE OF WELL: Driven Date Constructed 1938  
Depth drilled 21 feet Depth cased 21 feet

### CASING RECORD:

4 inch commercial well pipe set to 21 feet

### FINISH:

4' of 4" perforated regular pipe from 17 to 21 feet

### AQUIFERS:

### WATER LEVEL:

15 feet below surface

PUMPING EQUIPMENT: Type Electrifugal H.P. 7 1/2  
Capacity 500 G.P.M.

### WELL TESTS:

Drawdown 4 ft. after \_\_\_\_\_ hours 500 G.P.M.  
Drawdown \_\_\_\_\_ ft. after \_\_\_\_\_ hours \_\_\_\_\_ G.P.M.

USE OF WATER Irrigation Temp. \_\_\_\_\_ °F., 19

SOURCE OF INFORMATION Well Registration Statement

DRILLER or DIGGER Everett Scott

### ADDITIONAL DATA:

Log  Water Level Measurements \_\_\_\_\_ Chemical Analysis \_\_\_\_\_ Aquifer Test \_\_\_\_\_

### REMARKS:

Log:	Thickness	Depth to Bottom
Silt loam	2	2
Silty clay loam	2	4
Sand	4	8
Sand & gravel	13	21