

LANE  
6178


# Well Record

OWNER: Elsie P. Strome  
MAILING ADDRESS: 1425 Highway 99 E.

LOCATION OF WELL: Owner's No. \_\_\_\_\_  
CITY AND STATE: Junction City, Oregon

SW 1/4 SW 1/4 Sec. 20 T. 15 S. R. 4 W., W.M.

Bearing and distance from section or subdivision  
corner 6700' S. 45° 30' W. from NE cor. Sec. 20

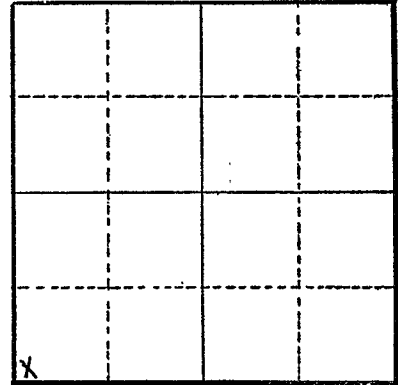

Section 20

Altitude at well \_\_\_\_\_

TYPE OF WELL: Driven Date Constructed 1938

Depth drilled 21 feet Depth cased 21 feet

### CASING RECORD:

4 inch commercial well pipe set to 21 feet

### FINISH:

4' of 4" perforated regular pipe from 17 to 21 feet

### AQUIFERS:

### WATER LEVEL:

10 feet below surface

PUMPING EQUIPMENT: Type John Deere Square D70L06M19G8 "A" H.P. 36  
Capacity 650 G.P.M.

### WELL TESTS:

Drawdown 4 ft. after \_\_\_\_\_ hours 650 G.P.M.  
Drawdown \_\_\_\_\_ ft. after \_\_\_\_\_ hours \_\_\_\_\_ G.P.M.

USE OF WATER Irrigation Temp. \_\_\_\_\_ °F. \_\_\_\_\_, 19\_\_\_\_

SOURCE OF INFORMATION Well Registration Statement

DRILLER or DIGGER Everett Scott

### ADDITIONAL DATA:

Log  Water Level Measurements \_\_\_\_\_ Chemical Analysis \_\_\_\_\_ Aquifer Test \_\_\_\_\_

### REMARKS:

Log:	Thickness	Depth to Bottom
Silt loam	2	2
Silty clay loam	2	4
Sand	4	10
Sand & gravel	13	21