

LANE  
6179


# Well Record

OWNER: Elsie P. Strome  
MAILING ADDRESS: 1435 Highway 99 E.

LOCATION OF WELL: Owner's No. \_\_\_\_\_  
CITY AND STATE: Junction City, Oregon

SE 1/4 SW 1/4 Sec. 20 T. 15 N. S., R. 4 W., W.M.

Bearing and distance from section or subdivision  
corner 5700' S. 35° W. from NE cor. Sec. 20

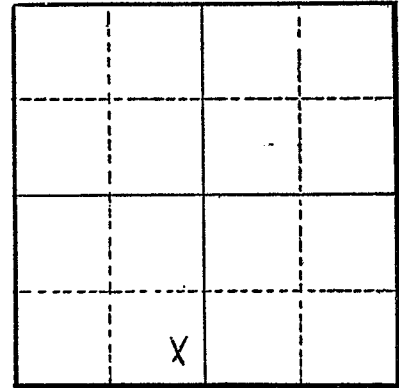

Section 20

Altitude at well \_\_\_\_\_

TYPE OF WELL: Driven Date Constructed 1935

Depth drilled 21 feet Depth cased 21 feet

### CASING RECORD:

4 inch commercial well pipe set to 21 feet

### FINISH:

4' of 4" perforated regular pipe from 17 to 21 feet

### AQUIFERS:

### WATER LEVEL:

10 feet below surface

PUMPING EQUIPMENT: Type Rain-0-flow H.P. 20  
Capacity 650 G.P.M.

### WELL TESTS:

Drawdown 4 ft. after \_\_\_\_\_ hours 650 G.P.M.  
Drawdown \_\_\_\_\_ ft. after \_\_\_\_\_ hours \_\_\_\_\_ G.P.M.

USE OF WATER Irrigation Temp. °F. \_\_\_\_\_, 19

SOURCE OF INFORMATION Well Registration Statement

DRILLER or DIGGER \_\_\_\_\_

### ADDITIONAL DATA:

Log  Water Level Measurements \_\_\_\_\_ Chemical Analysis \_\_\_\_\_ Aquifer Test \_\_\_\_\_

### REMARKS:

Log:

Silt loam  
Silty clay loam  
Sand  
Sand & gravel

Thickness	Depth to Bottom
2	2
2	4
4	10
13	21

3367