

STATE ENGINEER
Salem, Oregon

LANE
6209

Well Record


STATE WELL NO. 15/LW-28P
COUNTY Lane
APPLICATION NO. GR-3598

OWNER: Walter M. Petersen
MAILING ADDRESS: 401 Dane Lane

LOCATION OF WELL: Owner's No. _____
CITY AND STATE: Junction City, Oregon

SE 1/4 SW 1/4 Sec. 28 T. 15 S. R. 4 W., W.M.

Bearing and distance from section or subdivision
corner 2000' E. 755' N. of Sec. corner

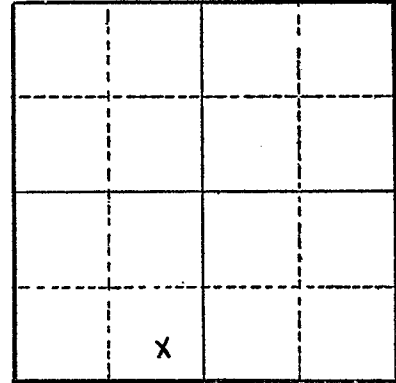

Section 28

Altitude at well _____

TYPE OF WELL: Driven Date Constructed June, 1947

Depth drilled 26 ft. Depth cased _____

CASING RECORD:

FINISH:

AQUIFERS:

WATER LEVEL:

12 feet below surface

PUMPING EQUIPMENT: Type Cornell centrifugal H.P. 15
Capacity 450 G.P.M.

WELL TESTS:

Drawdown 3 ft. after _____ hours 500 G.P.M.
Drawdown _____ ft. after _____ hours _____ G.P.M.

USE OF WATER Irrigation Temp. °F. _____, 19

SOURCE OF INFORMATION Well Registration Statement

DRILLER or DIGGER Walter Nelson

ADDITIONAL DATA:

Log X Water Level Measurements _____ Chemical Analysis _____ Aquifer Test _____

REMARKS:

Log:	Thickness	Depth to Bottom
Loam	10	20
Gravel	16	26