

STATE ENGINEER
Salem, Oregon

LANE
6210

Well Record


STATE WELL NO. 15/4W-28 R
COUNTY LANE
APPLICATION NO. GR-2597

OWNER: Wright H. Nickason
MAILING ADDRESS: 868 Willamette Drive

LOCATION OF WELL: Owner's No.
CITY AND STATE: Junction City, Oregon

SE 1/4 SE 1/4 Sec. 28 T. 15 N. 4 E. S. R. W., W.M.

Bearing and distance from section or subdivision corner
700' N. and 240' W.

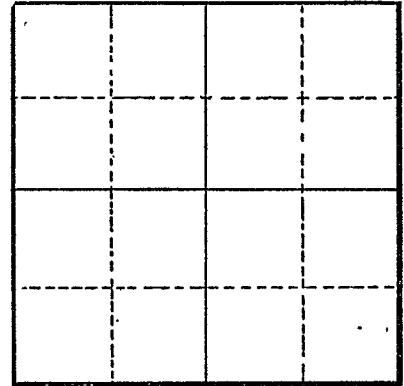

Section

Altitude at well

TYPE OF WELL: Driven Date Constructed 1946

Depth drilled 24 Depth cased 24

CASING RECORD:

4-inch

FINISH:

Slo heads from 20 to 24

AQUIFERS:

WATER LEVEL:

PUMPING EQUIPMENT: Type M.W. H.P. 10
Capacity 170 G.P.M.

WELL TESTS:

Drawdown ft. after hours G.P.M.
Drawdown ft. after hours G.P.M.

USE OF WATER Irrigation Temp. °F., 19

SOURCE OF INFORMATION GR-2464

DRILLER or DIGGER

ADDITIONAL DATA:

Log Water Level Measurements Chemical Analysis Aquifer Test

REMARKS: