

STATE ENGINEER  
Salem, Oregon

LANE  
6231

# Well Record

STATE WELL NO. 15/4W-29B(1)  
COUNTY Lane  
APPLICATION NO. ....

OWNER: Ethel J. Ridnour

MAILING

ADDRESS: 900 - 99 East

LOCATION OF WELL: Owner's No. 1

CITY AND

STATE: Junction City, Oregon

NW 1/4 NE 1/4 Sec. 29 T. 15 S. R. 4 W., W.M.

Bearing and distance from section or subdivision


corner 1235' S. & 2075' W. of NE cor. Sec. 29

Altitude at well 319 ft. Interpolated

TYPE OF WELL: driven Date Constructed Sept. 1957

Depth drilled 26 ft. Depth cased 26 ft.

CASING RECORD: 4 in. pipe driven to 26 ft.

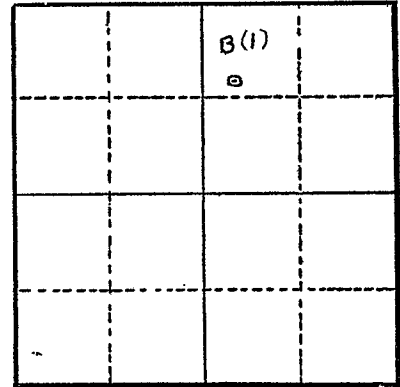

Section 29

FINISH: Perforations from 22 to 26 ft.

AQUIFERS: Sand & gravel from 5 to 26 ft.

WATER LEVEL: 12 ft. below land surface

PUMPING EQUIPMENT: Type Jacuzzi centrifugal single phase H.P. 5  
Capacity 200 G.P.M.

WELL TESTS:  
Drawdown 2 ft. after ? hours pumping 200 G.P.M.  
Drawdown ft. after hours G.P.M.

USE OF WATER irrigation 7 acres Temp. °F. 19

SOURCE OF INFORMATION

DRILLER or DIGGER

ADDITIONAL DATA:

Log X Water Level Measurements Chemical Analysis Aquifer Test

REMARKS: Log: Loam 0 - 5 ft.  
Sand & gravel 5 - 26 ft.