

STATE ENGINEER  
Salem, Oregon

LANE  
6232

# Well Record

STATE WELL NO. 15/4W-29B  
COUNTY LANE  
APPLICATION NO. GR-2587

OWNER: Isaac R. Howard


MAILING ADDRESS: Junction City, Oregon

LOCATION OF WELL: Owner's No. #1

CITY AND STATE:

NW 1/4 NE 1/4 Sec. 29 T. 15 S., R. 4 W., W.M.

Bearing and distance from section or subdivision corner 365' S. & 1650' W.

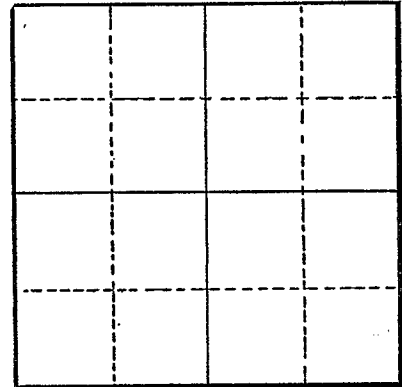

Section

Altitude at well

TYPE OF WELL: Driven Date Constructed 1953

Depth drilled 24 Depth cased 24

### CASING RECORD:

6-inch

### FINISH:

Standard Perforations from 21 to 24

### AQUIFERS:

Loam and sand and gravel

### WATER LEVEL:

12-feet

PUMPING EQUIPMENT: Type Cornell H.P. 15

Capacity 300 G.P.M.

### WELL TESTS:

Drawdown 2 ft. after hours Pumping 250 G.P.M.

Drawdown ft. after hours G.P.M.

USE OF WATER Irrigation Temp. °F., 19

SOURCE OF INFORMATION GR-2454

### DRILLER or DIGGER

### ADDITIONAL DATA:

Log  Water Level Measurements  Chemical Analysis  Aquifer Test

### REMARKS:

Loam	4	20
Sand & gravel	20	0