

STATE ENGINEER
Salem, Oregon

LANE
6235

Well Record


STATE WELL NO. 15/4W-29G
COUNTY Lane
APPLICATION NO. GR-4151

OWNER: Geo. H. Gilmore
MAILING ADDRESS: 700 Hwy. 99 E.

LOCATION OF WELL: Owner's No. _____
CITY AND STATE: Junction City, Oregon

SW 1/4 NE 1/4 Sec. 29 T. 15 N. S. R. 4 W., W.M.

Bearing and distance from section or subdivision corner 1275' N. 73° E. from center Sec. 29

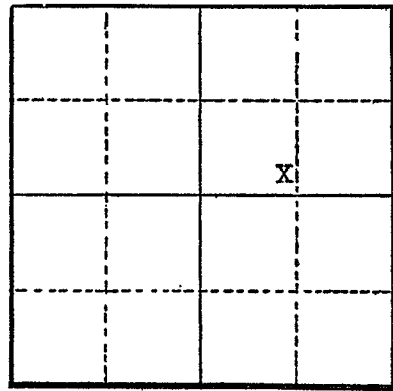

Section 29

Altitude at well _____

TYPE OF WELL: Driven Date Constructed 1940

Depth drilled 21 ft. Depth cased 21 ft.

CASING RECORD:

5 inch steel well casing set to 21 feet

FINISH:

6 - 1/2" x 5" vertical slote per foot from 0 to 5 feet

AQUIFERS:

WATER LEVEL:

8 feet below surface

PUMPING EQUIPMENT: Type Allis Chalmer centrifugal 3 x 4 H.P. 15
Capacity 500 G.P.M.

WELL TESTS:

Drawdown	ft. after	hours	G.P.M.
Drawdown	ft. after	hours	G.P.M.

USE OF WATER Irrigation Temp. °F. 19

SOURCE OF INFORMATION Well Registration Statement Cert. # GR-3720

DRILLER or DIGGER _____

ADDITIONAL DATA:

Log Water Level Measurements _____ Chemical Analysis _____ Aquifer Test _____

REMARKS:	Thickness	Depth to Bottom
Log		
Willamette loam	7	7
Sand	2	9
Sand & gravel	12	21