

LANE
6236


Well Record

OWNER: Geo. H. Gilmore
MAILING ADDRESS: 700 Hwy. 99 E.

LOCATION OF WELL: Owner's No. CITY AND STATE: Junction City, Oregon

SE 1/4 NE 1/4 Sec. 29 T. 15 S., R. 4 W., W.M.

Bearing and distance from section or subdivision corner 2520' S. 89° E. from center Sec. 29

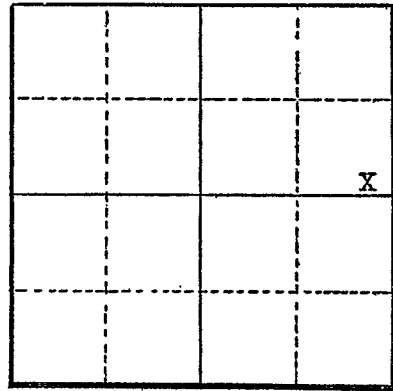

Section 29

Altitude at well

TYPE OF WELL: Driven Date Constructed 1942

Depth drilled 30 ft. Depth cased 30 ft.

CASING RECORD:

4 inch steel casing set to 30 ft.

FINISH:

4 - 1/2" x 5" vertical slots per foot from 0 to 5 feet

AQUIFERS:

WATER LEVEL:

8 feet below surface

PUMPING EQUIPMENT: Type Cornell centrifugal 3" x 4" H.P. 15
Capacity 400 G.P.M.

WELL TESTS:

Drawdown ft. after hours G.P.M.
Drawdown ft. after hours G.P.M.

USE OF WATER Irrigation Temp. °F., 19

SOURCE OF INFORMATION Well Registration Statement Cert. # GR-3719

DRILLER or DIGGER

ADDITIONAL DATA:

Log Water Level Measurements Chemical Analysis Aquifer Test

REMARKS: Log	Thickness	Depth to Bottom
Sandy loam	5	5
Clay	4	9
Sand	3	12
Sand & gravel	18	30