

STATE ENGINEER
Salem, Oregon

LANE
6238

Well Record

STATE WELL NO. 15/~~AW~~-29L
COUNTY Lane
APPLICATION NO. GR-1405

GR- 1360

OWNER: Jennie Claridge


MAILING ADDRESS: Rt. 2

LOCATION OF WELL: Owner's No.

CITY AND STATE: Junction City, Oregon

NE 1/4 SW 1/4 Sec. 29 T. 15 S. R. 4 W., W.M.

Bearing and distance from section or subdivision corner 2440' E. & 200' S. from W¹/₄ cor. Sec. 29

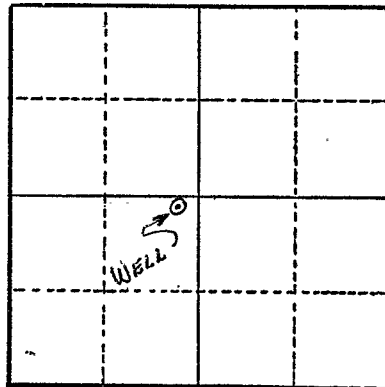

Section 29

Altitude at well

TYPE OF WELL: Driven Date Constructed 1944

Depth drilled 21 ft. Depth cased 21 ft.

CASING RECORD:

4 inch

FINISH:

Perforated but later blasted

AQUIFERS:

WATER LEVEL:

10 ft.

PUMPING EQUIPMENT: Type Cent. H.P. 3
Capacity 120 G.P.M.

WELL TESTS:

Drawdown ft. after hours G.P.M.
Drawdown ft. after hours G.P.M.

USE OF WATER Irrigation Temp. °F., 19

SOURCE OF INFORMATION G. R. Record

DRILLER or DIGGER

ADDITIONAL DATA:

Log N.A. Water Level Measurements Chemical Analysis Aquifer Test

REMARKS:

Irrigation of 4.25 acres.