

STATE ENGINEER
Salem, Oregon

LANE
6243

Well Record

STATE WELL NO. 15/4W-290
COUNTY Lane
APPLICATION NO. GR-1284

GR- 1241

OWNER: Jens Reerslev

MAILING

ADDRESS: 220 E. 18 th

LOCATION OF WELL: Owner's No.


CITY AND

STATE: Junction City, Oregon

SW ^{XX} 1/4 SE ^{EX} 1/4 Sec. 29 T. 15 S., R. 4 W., W.M.

Bearing and distance from section or subdivision

corner N73°E. 3425' from SW cor. Sec. 29.

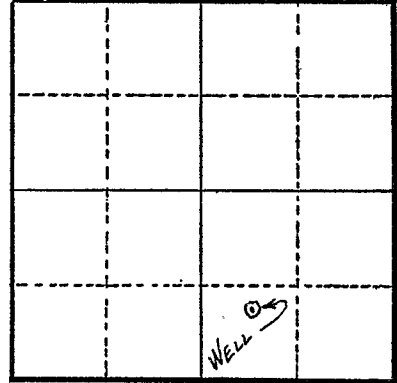

Section 29

Altitude at well 421 ft.

TYPE OF WELL: Driven Date Constructed 1952

Depth drilled 24 ft. Depth cased 24 ft.

CASING RECORD:

5 inch

FINISH:

Perforated: 35 (1/4 x 4 in.) slots from 20 to 24 ft.

AQUIFERS:

Small gravel & sand

WATER LEVEL:

12 ft.

PUMPING EQUIPMENT: Type Cornell 3 in. Cent.

H.P. 15

Capacity 400 G.P.M.

WELL TESTS:

Drawdown 4 ft. after 400 hours G.P.M.

Drawdown ft. after hours G.P.M.

USE OF WATER Irrigation Temp. °F., 19

SOURCE OF INFORMATION G. R. Record

DRILLER or DIGGER Walter Nelson

ADDITIONAL DATA:

Log N.A. Water Level Measurements Chemical Analysis Aquifer Test

REMARKS:

Irrigation of 64.3 acres.