

STATE ENGINEER
Salem, Oregon

LANE
6244

Well Record

STATE WELL NO. 15/4W-29R
COUNTY Lane
APPLICATION NO. GR-1285

GR- 1242

OWNER: Jens Reerslev


MAILING ADDRESS: 220 E. 18. th

LOCATION OF WELL: Owner's No. #2

CITY AND STATE: Junction City, Oregon

SE 1/4 SE 1/4 Sec. 29 T. 15 S., R. 4 W., W.M.

Bearing and distance from section or subdivision corner 5160' N87°E. from SW cor. Sec. 29.

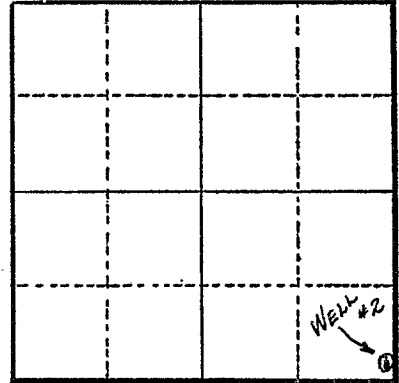

Section 29

Altitude at well 421 ft.

TYPE OF WELL: Driven Date Constructed 1947

Depth drilled 21 ft. Depth cased 21 ft.

CASING RECORD:

4 inch

FINISH:

Perforated : 1/4 x 4 in. from 17 to 21 ft.

AQUIFERS:

Fine gravel & sand

WATER LEVEL:

12 ft.

PUMPING EQUIPMENT: Type Pacific 3 in. H.P. Tractor
Capacity 400 G.P.M.

WELL TESTS:

Drawdown 4 ft. after 300 hours G.P.M.
Drawdown ft. after hours G.P.M.

USE OF WATER Irrigation Temp. °F. 19

SOURCE OF INFORMATION G. R. Record

DRILLER or DIGGER Walter Nelson

ADDITIONAL DATA:

Log N. A. Water Level Measurements Chemical Analysis Aquifer Test

REMARKS:

Irrigation of 30.8 acres.