

STATE ENGINEER  
Salem, Oregon

LANE  
6245

# Well Record

STATE WELL NO. 15/44-29R(2)  
COUNTY Lane  
APPLICATION NO. GR-1286

GR- 1243

OWNER: Jens Reerslev

MAILING

ADDRESS: 220 E. 18 th

LOCATION OF WELL: Owner's No. #3


CITY AND

STATE: Junction City, Oregon

SE 1/4 SE 1/4 Sec. 29 T. 15 S., R. 4 W., W.M.

Bearing and distance from section or subdivision

corner 5350' N76°E. from SW cor. Sec. 29.

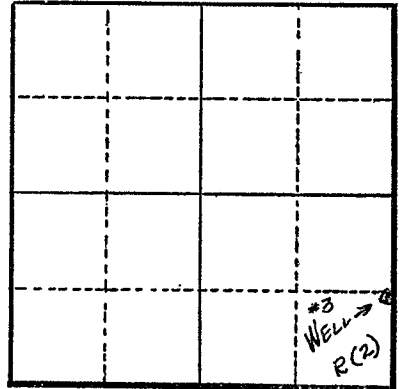

Section 29

Altitude at well 421 ft.

TYPE OF WELL: Driven Date Constructed 1944

Depth drilled 21 ft. Depth cased 21 ft.

### CASING RECORD:

3 inch

### FINISH:

Perforated from ?????

### AQUIFERS:

Gravel & sand

### WATER LEVEL:

12 ft.

PUMPING EQUIPMENT: Type Pacific 3 in.

H.P. Tractor

Capacity 400 G.P.M.

### WELL TESTS:

Drawdown 4 ft. after hours 300 G.P.M.

Drawdown ft. after hours G.P.M.

USE OF WATER Irrigation Temp. °F., 19

SOURCE OF INFORMATION G. R. Record

DRILLER or DIGGER Walter Nelson

### ADDITIONAL DATA:

Log N.A. Water Level Measurements Chemical Analysis Aquifer Test

### REMARKS:

Irrigation of 58.11 acres.