

STATE ENGINEER  
Salem, Oregon

LANE  
6282

# Well Record

STATE WELL NO. 15/4W-30 & 29  
COUNTY LANE  
APPLICATION NO. GR-2936

OWNER: Earl J. Wheeler

MAILING ADDRESS: 485 Taftdahl Lane


LOCATION OF WELL: Owner's No. #2

CITY AND STATE: Junction City, Oregon

SE NE  
SW NW 30&29 15 N. 4 E.  
1/4 1/4 Sec. T. S., R. W., W.M.

Bearing and distance from section or subdivision

corner 3080' N.

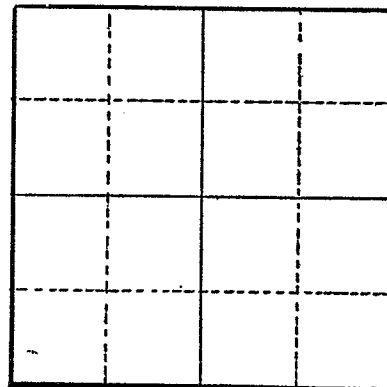

Section

Altitude at well

TYPE OF WELL: driven Date Constructed 1948

Depth drilled 25 Depth cased 25

### CASING RECORD:

4-inch

### FINISH:

Standard perforations from 21 to 25

### AQUIFERS:

Loam, sand & gravel

### WATER LEVEL:

12-feet

### PUMPING EQUIPMENT: Type

Cornell Centrifugal

H.P. 3

Capacity 150 G.P.M.

### WELL TESTS:

Drawdown 3 ft. after hours Pumping 200 G.P.M.

Drawdown ft. after hours G.P.M.

USE OF WATER Irrigation

Temp. °F. 19

SOURCE OF INFORMATION GR-2761

DRILLER or DIGGER

### ADDITIONAL DATA:

Log  Water Level Measurements Chemical Analysis Aquifer Test

### REMARKS:

Loam	10	15
Sand & gravel	15	0