

STATE ENGINEER
Salem, Oregon

LANE
6285

Well Record

STATE WELL NO. 15/4W-30A
COUNTY LANE
APPLICATION NO. GR-2775

OWNER: Charlie F. Packnett


MAILING ADDRESS:

LOCATION OF WELL: Owner's No.

CITY AND STATE: Junction City, Oregon

NE NE
1/4 1/4 Sec. 30 T. 15 S., R. 4 W., W.M.

Bearing and distance from section or subdivision corner 1150' S & 200' W from NE cor Sec 30

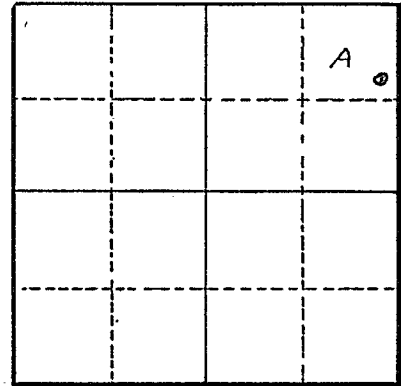

Section 30

Altitude at well

TYPE OF WELL: Driven Date Constructed 1950

Depth drilled 20' Depth cased

CASING RECORD:

FINISH:

AQUIFERS:

WATER LEVEL:

10'

PUMPING EQUIPMENT: Type Jacuzzi H.P. 5
Capacity 250 G.P.M.

WELL TESTS:

Drawdown ft. after hours 225 G.P.M.
Drawdown ft. after hours G.P.M.

USE OF WATER Irrigation Temp. °F., 19

SOURCE OF INFORMATION GR-3948

DRILLER or DIGGER

ADDITIONAL DATA:

Log NA Water Level Measurements Chemical Analysis Aquifer Test

REMARKS: