

STATE ENGINEER
Salem, Oregon

LANE
6286

Well Record


STATE WELL NO. 15/LW - 30A
COUNTY LANE
APPLICATION NO. GR-2238

OWNER: Niels H. Borggaard MAILING ADDRESS: 1050 Toftdahl Lane Route 3

LOCATION OF WELL: Owner's No. CITY AND STATE: Junction City, Oregon

NE 1/4 NE 1/4 Sec. 30 T. 15 N. S., R. 4 W., W.M.

Bearing and distance from section or subdivision corner 490' S. and 130' W.

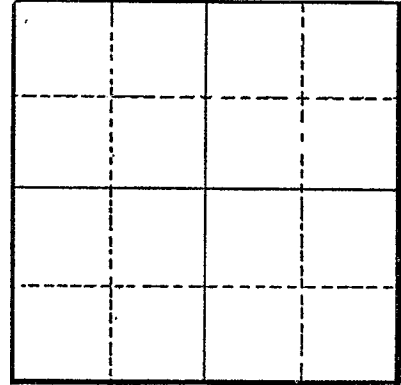

Section

Altitude at well

TYPE OF WELL: Driven Date Constructed 1950

Depth drilled 20 Depth cased 20

CASING RECORD:

4-Inch

FINISH:

Perforations from 17 to 20

AQUIFERS:

Loam, sand and gravel

WATER LEVEL:

12-Feet

PUMPING EQUIPMENT: Type Peerless Centrifugal H.P. 5
Capacity 160 G.P.M.

WELL TESTS:

Drawdown 2 ft. after hours Pumping 250 G.P.M.

Drawdown ft. after hours G.P.M.

USE OF WATER Irrigation Temp. °F., 19

SOURCE OF INFORMATION GR-2139

DRILLER or DIGGER

ADDITIONAL DATA:

Log ^X Water Level Measurements Chemical Analysis Aquifer Test

REMARKS:

Loam 4 16
Sand & Gravel 16 0