

STATE ENGINEER
Salem, Oregon

Well Record

STATE WELL NO. 15/4W-30F
COUNTY LANE
APPLICATION NO. GR-2933

LANE
6289

OWNER: Sigurd Nielsen

MAILING ADDRESS: 1596 Oakles Dr.


LOCATION OF WELL: Owner's No. _____

CITY AND STATE: Junction City, Oregon

SE 1/4 NW 1/4 Sec. 30 T. 15 ^{N.}S., R. 4 ^{E.}W., W.M.

Bearing and distance from section or subdivision

corner 2000' E. thence 1525' S.

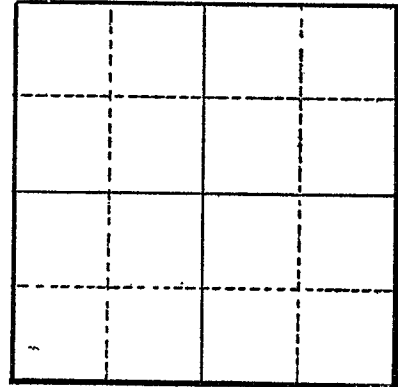

Section _____

Altitude at well _____

TYPE OF WELL: driven Date Constructed 1946

Depth drilled 23 Depth cased 23

CASING RECORD:

4-inch

FINISH:

AQUIFERS:

WATER LEVEL:

8-feet

PUMPING EQUIPMENT: Type Rain flow H.P. 15
Capacity 400 G.P.M.

WELL TESTS:

Drawdown _____ ft. after _____ hours _____ Pumping 400 G.P.M.

Drawdown _____ ft. after _____ hours _____ G.P.M.

USE OF WATER Irrigation Temp. _____ °F., 19 _____

SOURCE OF INFORMATION GR-2759

DRILLER or DIGGER Walter Nelson

ADDITIONAL DATA:

Log _____ Water Level Measurements _____ Chemical Analysis _____ Aquifer Test _____

REMARKS: