

LANE
6290

Well Record

OWNER: Sigurd Nielsen


MAILING ADDRESS: 1596 Oaklea Drive

LOCATION OF WELL: Owner's No.

CITY AND STATE: Junction City, Oregon

SW 1/4 NE 1/4 Sec. 30 T. 15 N S, R. 4 W, W.M.

Bearing and distance from section or subdivision corner 2420' W. thence 1630' S. from N.E. Corner Section 30

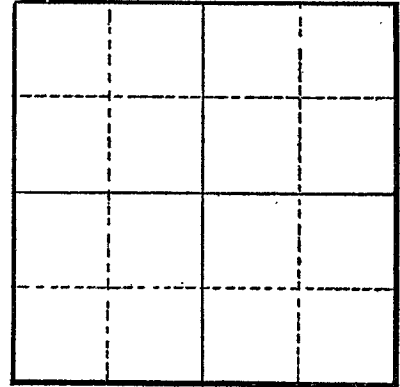

Section

Altitude at well

TYPE OF WELL: driven Date Constructed 1945

Depth drilled 21 Depth cased 21

CASING RECORD:

4 inch

FINISH:

AQUIFERS:

WATER LEVEL:

7 feet

PUMPING EQUIPMENT: Type rain flow H.P. 15
Capacity 400 G.P.M.

WELL TESTS:

Drawdown ft. after hours pumping 400 G.P.M.
Drawdown ft. after hours G.P.M.

USE OF WATER Irrigation Temp. °F., 19

SOURCE OF INFORMATION GR-2840

DRILLER or DIGGER Walter Nelson

ADDITIONAL DATA:

Log Water Level Measurements Chemical Analysis Aquifer Test

REMARKS: