

STATE ENGINEER  
Salem, Oregon

LANE  
6291

# Well Record

GR- 1703


STATE WELL NO. 15/4W-30G  
COUNTY Lane  
APPLICATION NO. GR- 1758

OWNER: Gordon F. Kelso  
MAILING ADDRESS: Rt. 3

LOCATION OF WELL: Owner's No. #1  
CITY AND STATE: Junction City, Oregon

SW 1/4 NE 1/4 Sec. 30 T. 15 S., R. 4 W., W.M.

Bearing and distance from section or subdivision  
corner 2940' N. & 1450' W. from SE cor. Sec. 30

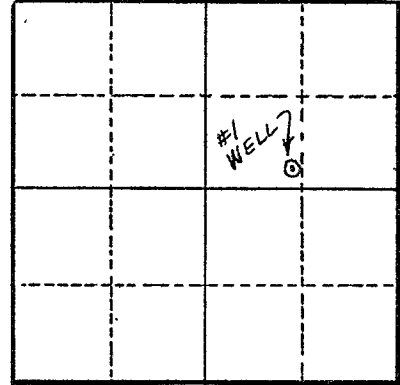

Altitude at well 315'

TYPE OF WELL: Driven Date Constructed 1953

Depth drilled 26.5' Depth cased 26.5'

Section 30

### CASING RECORD:

4"

### FINISH:

Standard perforations from 23.5 to 26.5 ft.

### AQUIFERS:

### WATER LEVEL:

22'

PUMPING EQUIPMENT: Type Wards 2" Cent. H.P. 5  
Capacity 200 G.P.M.

### WELL TESTS:

Drawdown 2 ft. after hours 500 G.P.M.

Drawdown ft. after hours G.P.M.

USE OF WATER Irrigation Temp. °F., 19

SOURCE OF INFORMATION GR Record

DRILLER or DIGGER

### ADDITIONAL DATA:

Log Water Level Measurements Chemical Analysis Aquifer Test

### REMARKS:

Log:	Loam	0 to 3 ft.
	Clay	3 to 8 ft.
	Sand & gravel	8 to 26.5 ft.

Irrigation of 20 acres.