

STATE ENGINEER
Salem, Oregon

LANE
6292


Well Record

STATE WELL NO. 15/4W-30H
COUNTY Lane
APPLICATION NO. GR-3596

OWNER: Keith W. Dainard
MAILING ADDRESS: 620.99.W.

LOCATION OF WELL: Owner's No. _____
CITY AND STATE: Junction City, Oregon

SE 1/4 NE 1/4 Sec. 30 T. 15 S., R. 4 W., W.M.
Bearing and distance from section or subdivision
corner 294.0' N. & 468' W. from SE cor. Sec. 30

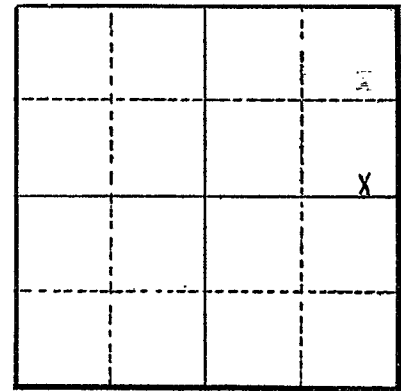

Section 30

Altitude at well _____

TYPE OF WELL: Driven Date Constructed 1950

Depth drilled 21 ft. Depth cased 21 ft.

CASING RECORD:

4 inch casing set to 21 feet

FINISH:

standard perforations from 18 to 21 feet

AQUIFERS:

sediments

WATER LEVEL:

8 feet below surface

PUMPING EQUIPMENT: Type Cornell centrifugal electric H.P. 5
Capacity 160 G.P.M.

WELL TESTS:

Drawdown 2 ft. after 300 hours G.P.M.
Drawdown _____ ft. after _____ hours G.P.M.

USE OF WATER Irrigation Temp. °F. 19

SOURCE OF INFORMATION Well Registration Statement

DRILLER or DIGGER _____

ADDITIONAL DATA:

Log Water Level Measurements _____ Chemical Analysis _____ Aquifer Test _____

REMARKS:

Log:	Thickness	Depth to Bottom
Loam top soil	4	17
Sand & gravel	17	0