

STATE ENGINEER
Salem, Oregon

LANE
6293

Well Record

STATE WELL NO. 15/4W-30J
COUNTY Lane
APPLICATION NO. GR-1768

GR- 1715

OWNER: Jack Moya


MAILING ADDRESS: P.O. Box 318

LOCATION OF WELL: Owner's No.

CITY AND STATE: Junction City, Oregon

NE 1/4 SE 1/4 Sec. 30 T. 15 S., R. 4 W., W.M.

Bearing and distance from section or subdivision corner 2353' N. 12°30'W. from SE cor. Sec. 30

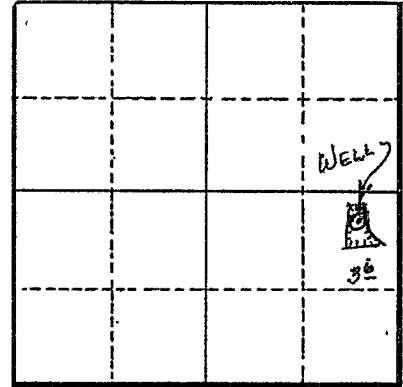

Section 30

Altitude at well 400'

TYPE OF WELL: Driven Date Constructed 1948

Depth drilled 28' Depth cased 28'

CASING RECORD:

4"

FINISH:

32 perforations (1/4" x 4") from 24 to 28 ft.

AQUIFERS:

WATER LEVEL:

10'

PUMPING EQUIPMENT: Type H.P. 5

Capacity 150 G.P.M.

WELL TESTS:

Drawdown 5 ft. after 200 hours G.P.M.

Drawdown ft. after hours G.P.M.

USE OF WATER Irrigation & Domestic Temp. °F., 19

SOURCE OF INFORMATION GR Record

DRILLER or DIGGER Walt Nelson

ADDITIONAL DATA:

Log Water Level Measurements Chemical Analysis Aquifer Test

REMARKS:

Log: Loam 0 to 10 ft.
Loose gravel 10 to 28 ft.

Irrigation of 3.6 acres.