

STATE ENGINEER  
Salem, Oregon

LANE  
6295

# Well Record

STATE WELL NO. 15/4W-30L  
COUNTY LANE  
APPLICATION NO. GR-2937

OWNER: Earl J. Wheeler


MAILING ADDRESS: 485 Taftdahl Lane

LOCATION OF WELL: Owner's No. #1

CITY AND STATE: Junction City, Oregon

NE 1/4 SW 1/4 Sec. 30 T. 15 N. 4 E. S., R. W., W.M.

Bearing and distance from section or subdivision corner 2500' N. and 200' W.

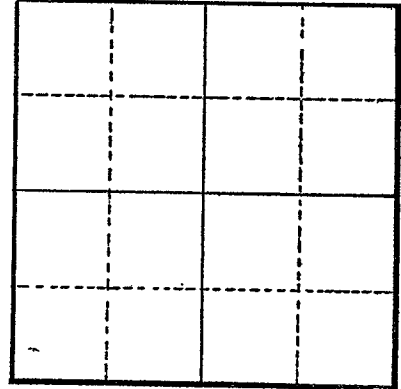

Section

Altitude at well

TYPE OF WELL: driven Date Constructed 1948

Depth drilled 25 Depth cased 25

### CASING RECORD:

4-inch

### FINISH:

Standard perforations from 21 to 25

### AQUIFERS:

Loam, sand & gravel

### WATER LEVEL:

12-feet

PUMPING EQUIPMENT: Type Cornell Centrifugal Capacity 150 G.P.M.

H.P. 3

### WELL TESTS:

Drawdown 3 ft. after hours Pumping 200 G.P.M.

Drawdown ft. after hours G.P.M.

USE OF WATER Irrigation

Temp. °F. 19

SOURCE OF INFORMATION GR-2762

DRILLER or DIGGER

### ADDITIONAL DATA:

Log  Water Level Measurements  Chemical Analysis  Aquifer Test

### REMARKS:

Loam	10	15
Sand & gravel	15	0